


AMENDMENTS:		
AMENDMENT	DATE	DESCRIPTION

- NOTES:
1. This plan has been prepared to show sewer, stormwater & water asbuilt locations only. No liability is accepted if the plan is used for any other purpose.
 2. Any measurements taken from information which is not dimensioned on the electronic copy are at the risk of the recipient.
 3. Stormwater laterals are Ø100mm uPVC.
 4. Asbuilt service locations have been provided by BG Contracting Ltd. No liability is accepted in relation to their accuracy.

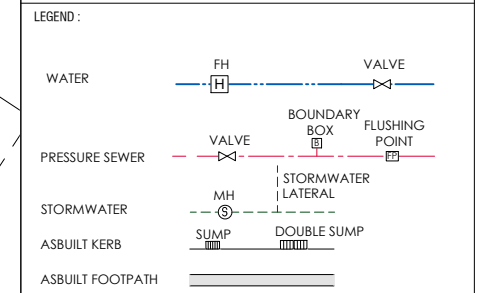

116 Wrights Road P O Box 679 Christchurch 8140. New Zealand
 Telephone: 03 379-0793 Website: www.dls.co.nz E-mail: office@dls.co.nz


JOB TITLE:
Meadowlands Stages 4 & 5

SHEET TITLE:
Asbuilt Sewer, Stormwater & Water

DRAWING STATUS:
For Information Purposes

SCALE: 1:500@A1 DATE: August 2022
 1:1000@A3

CAD FILE: \\s:\2011\ASBUILT\STAGES 4 & 5\E20114 STG-4 & 5 SERVICES PLAN_R0.dwg DRAWN: JS
 DRAWING No: **E.20114** SHEET No: **SP01.0** REVISION: **R0**

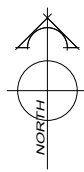

AMENDMENTS:		
AMENDMENT	DATE	DESCRIPTION

NOTES:

- This plan has been prepared to show sewer, stormwater & water asbuilt locations only. No liability is accepted if the plan is used for any other purpose.
- Any measurements taken from information which is not dimensioned on the electronic copy are at the risk of the recipient.
- Stormwater laterals are Ø100mm uPVC.
- Asbuilt service locations have been provided by BG Contracting Ltd. No liability is accepted in relation to their accuracy.

LEGEND:

WATER		
PRESSURE SEWER		
STORMWATER		
ASBUILT KERB		
ASBUILT FOOTPATH		

DAVIE LOVELL-SMITH
PLANNING SURVEYING ENGINEERING

116 Wrights Road P O Box 679 Christchurch 8140. New Zealand
Telephone: 03 379-0793 Website: www.dls.co.nz E-mail: office@dls.co.nz

JOB TITLE:
Meadowlands Stages 4 & 5

SHEET TITLE:
Asbuilt Sewer, Stormwater & Water

DRAWING STATUS:
For Information Purposes

SCALE: 1:500@A1 DATE: August 2022
1:1000@A3

CAD FILE: \\11\2011\ASBUILT\STAGES 4 & 5\E20114 STG-4 & 5 SERVICES PLAN_R0.dwg DRAWN: JS
DRAWING No: SHEET No: REVISION:

E.20114 SP02.0 R0